

#359

PLANS APPROVED
In accordance with
Sections 1 and 3
Ordinance 11,416

Rodman M. Brown

CHIEF ENGINEER
BUILDING DEPARTMENT

DATE ~~10-9-18~~ ~~Per # 179~~


4-8-18 Per # 179

*Gospel Hall
Church*




1322 N 45th


7150 L-1+2

Walnut Hill

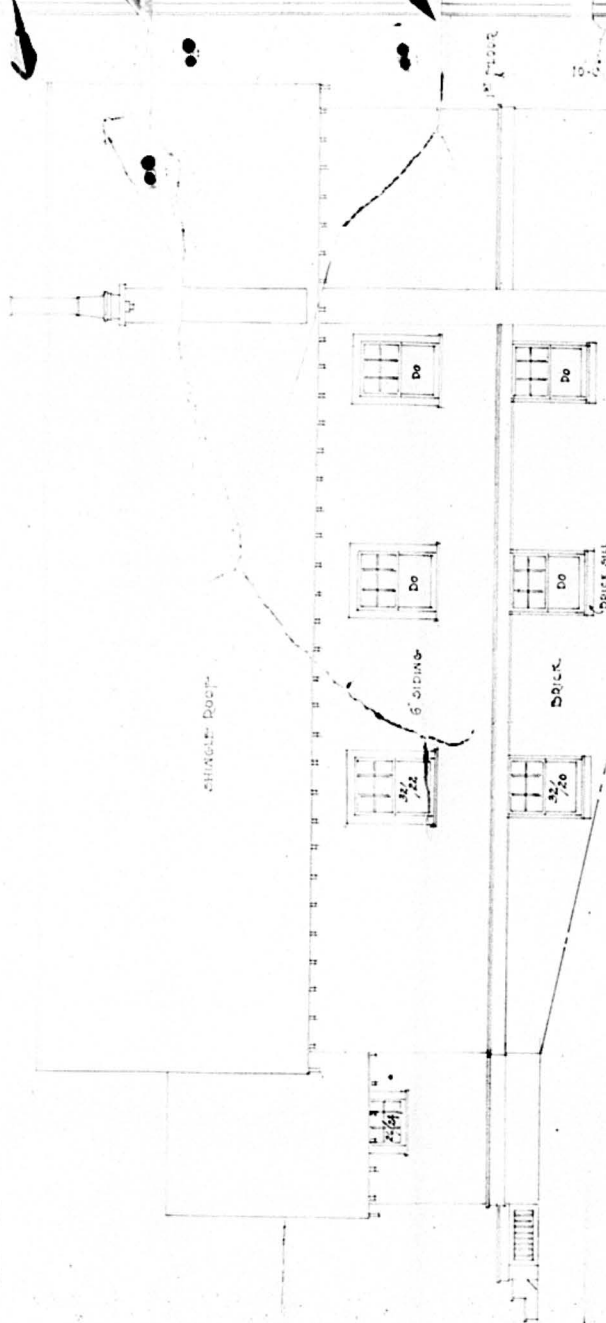


• SIDE VIEW •

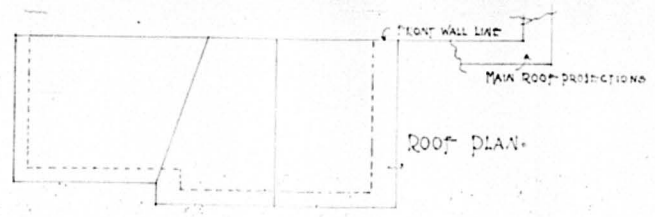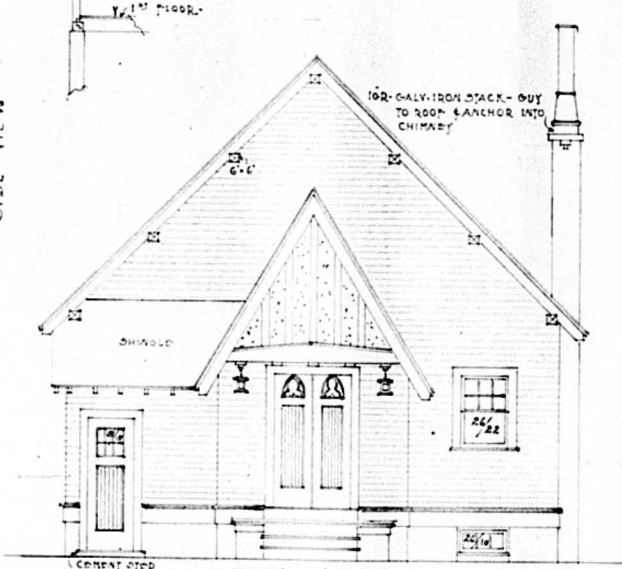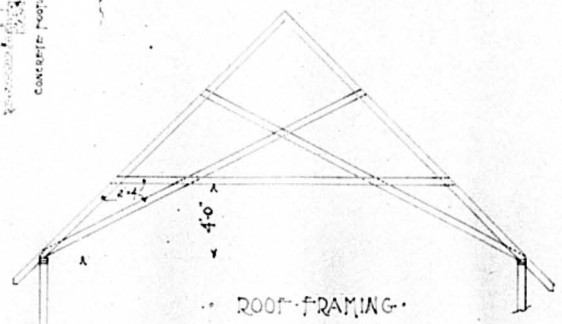

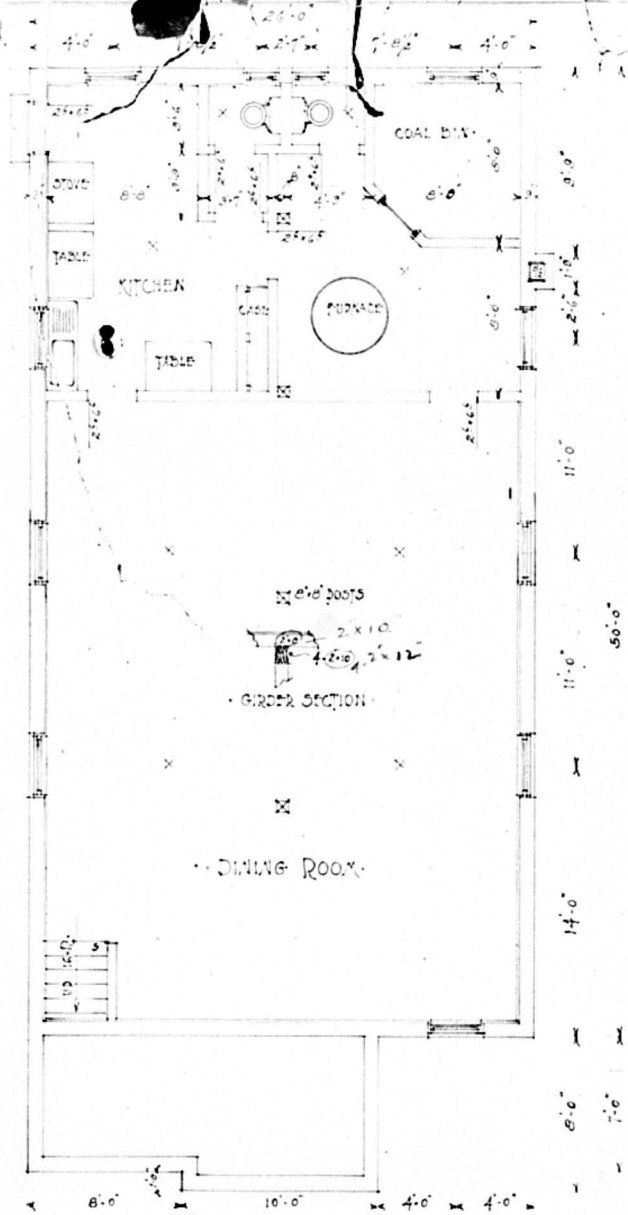

• BASEMENT PLAN •

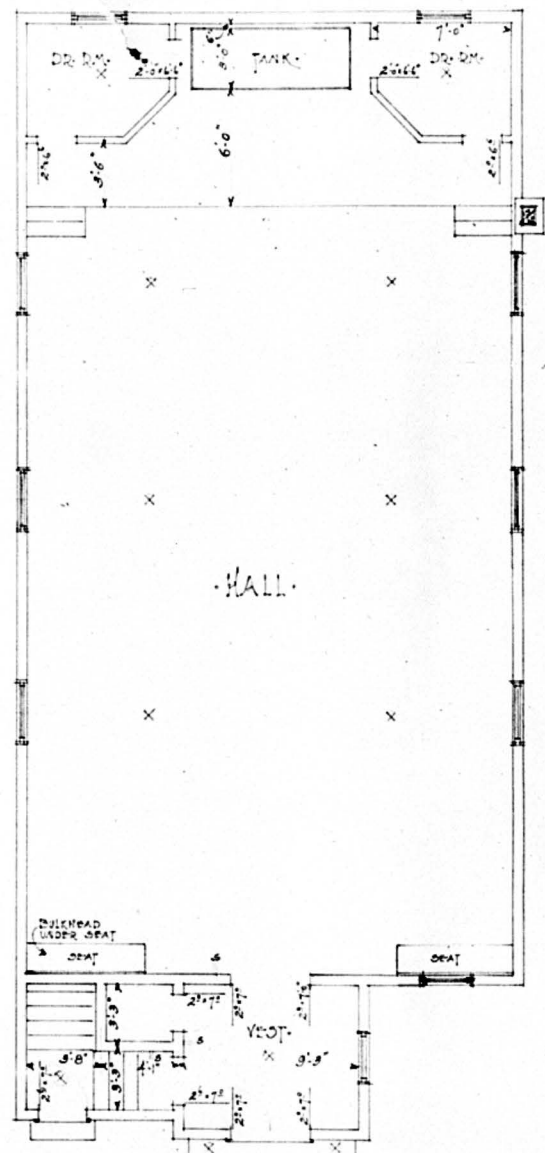

• MAIN FLOOR PLAN •

BRETHREN
MEETING HOUSE
45th & HAMILTON
SCALE 1/4" = 1'-0"
A. B. GRIFFIN
ARCHT.